

**PROSPECTIVE DEVELOPMENT**

**PROSPECTIVE DEVELOPMENT**

**PROSPECTIVE DEVELOPMENT**

PROJECT NO. 4828212	DATE: 12/11/2014
DATE: 12/11/2014	SCALE: 1/4" = 1'-0"
PROJECT NO. 4828212	DATE: 12/11/2014

**PROSPECTIVE DEVELOPMENT**




**LANGAN**  
INCORPORATED  
ARCHITECTS

**BERKELEY COURT  
PHASE 2**  
APARTMENT PROJECT

**SITE PLAN  
(RECORD PLAN)**

**CS-100**

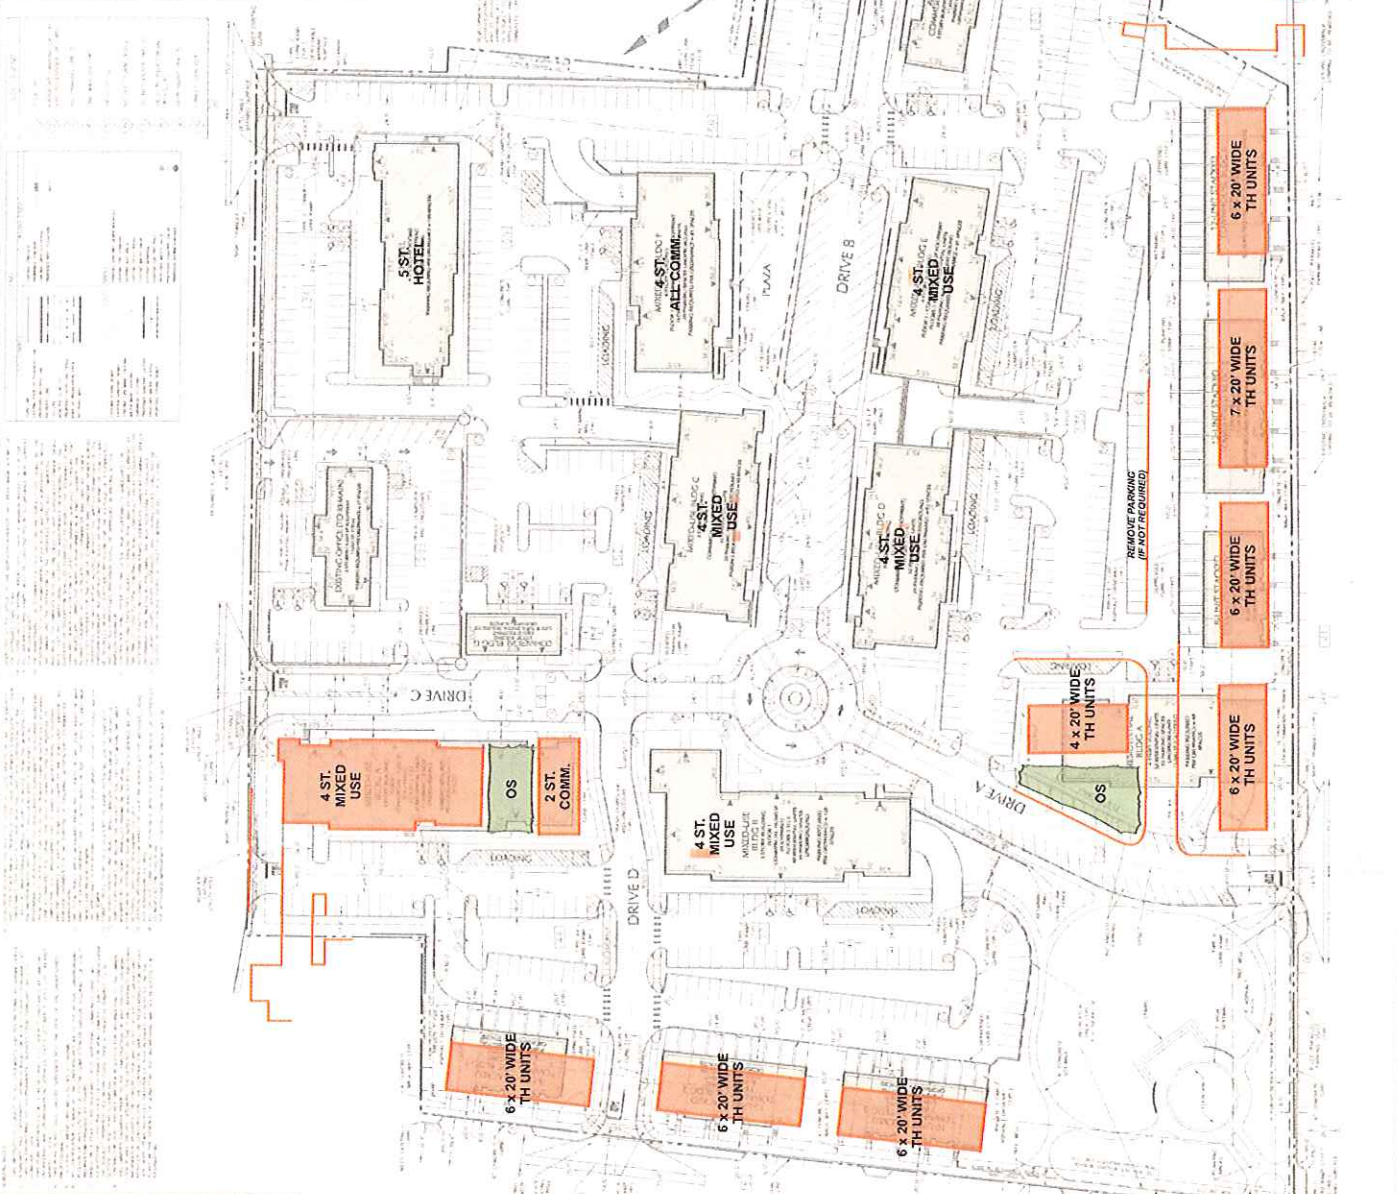

PROJECT NO. 4828212	DATE: 12/11/2014
PROJECT NO. 4828212	DATE: 12/11/2014
**Kennedy & Associates**

REGISTERED PROFESSIONAL ARCHITECTS AND ENGINEERS

117084